



December 19, 2019

Dave Crimp, PE
Clearwater Engineering
38934 Marys River Road
Blodgett, OR 97326

Re: **Water Tanks Replacement Projects (PR#62-2016)**
CHR District Improvement Co (PWS ID#00600)
Final Approval

Dear Mr. Crimp:

Thank you for your submittal to the Oregon Health Authority’s Drinking Water Services (DWS) of the completed *Request for Project Update* form we received on December 17, 2019. On December 19, 2019 you also provided the as-built plans and a copy of your letter addressing the conditions in the *Conditional Approval* letter Carrie Gentry sent dated June 6, 2016. **The project is granted Final Approval and the facilities may be placed into service.**


The project included replacement of the water system’s two existing reservoirs with two new 50,000-gallon Aquastore glass lined bolted steel reservoirs installed on the same site as the old reservoirs at T6S R11W Sec 14 TL1600 as shown below:



LOCATION MAP
TILLAMOOK COUNTY
T6S R11W TL1600



PROJECT SITE

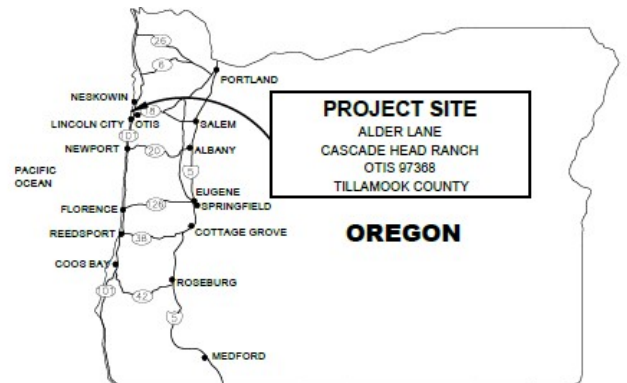


VICINITY MAP




WATER STORAGE TANKS (WORK THIS CONTRACT)


NO. TANKS	2 tanks
TYPE	Glass-lined bolted steel
VOLUME, EACH	49,090 gallons
VOLUME, BOTH	98,180 gallons
INSIDE DIAMETER	28.0 feet
SIDEWALL HEIGHT	15.0 feet
WATER LEVEL	10.64 feet
FREEBOARD	4.36 feet

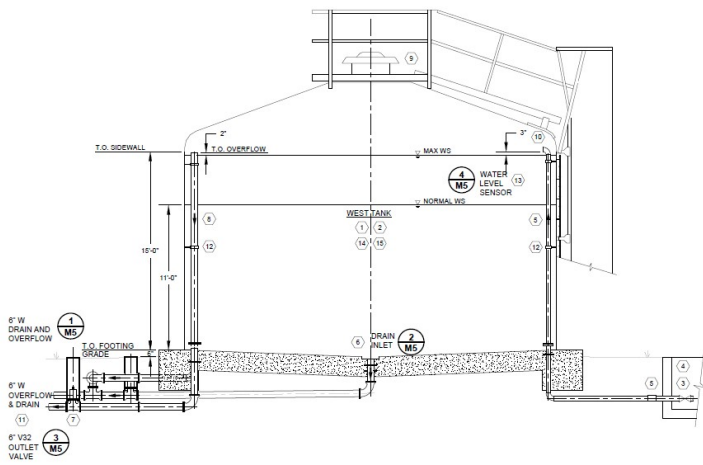


1 WEST TANK PIPING SECTION
 M2

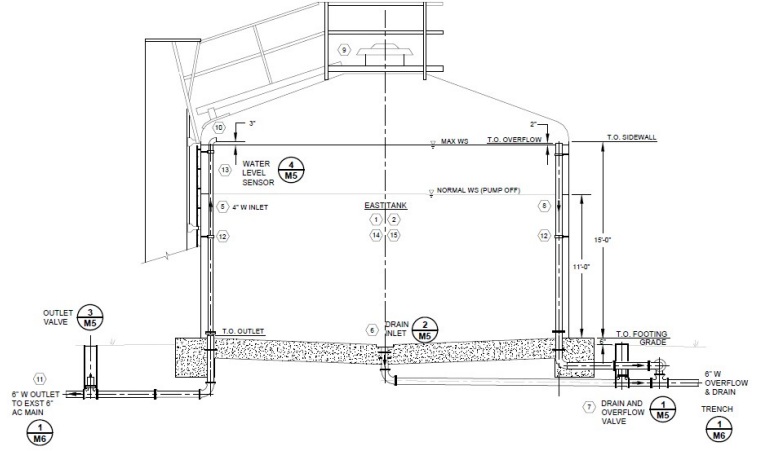

1 EAST TANK PIPING SECTION
 M4

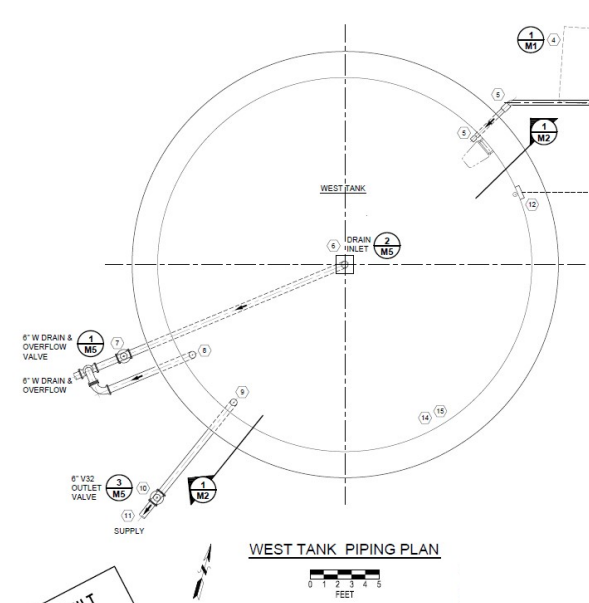


WEST TANK PIPING PLAN

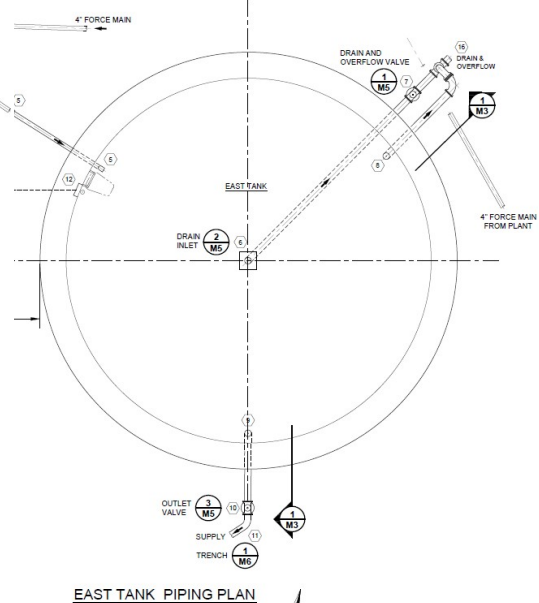

EAST TANK PIPING PLAN

AS BUILT
 OCTOBER 2017

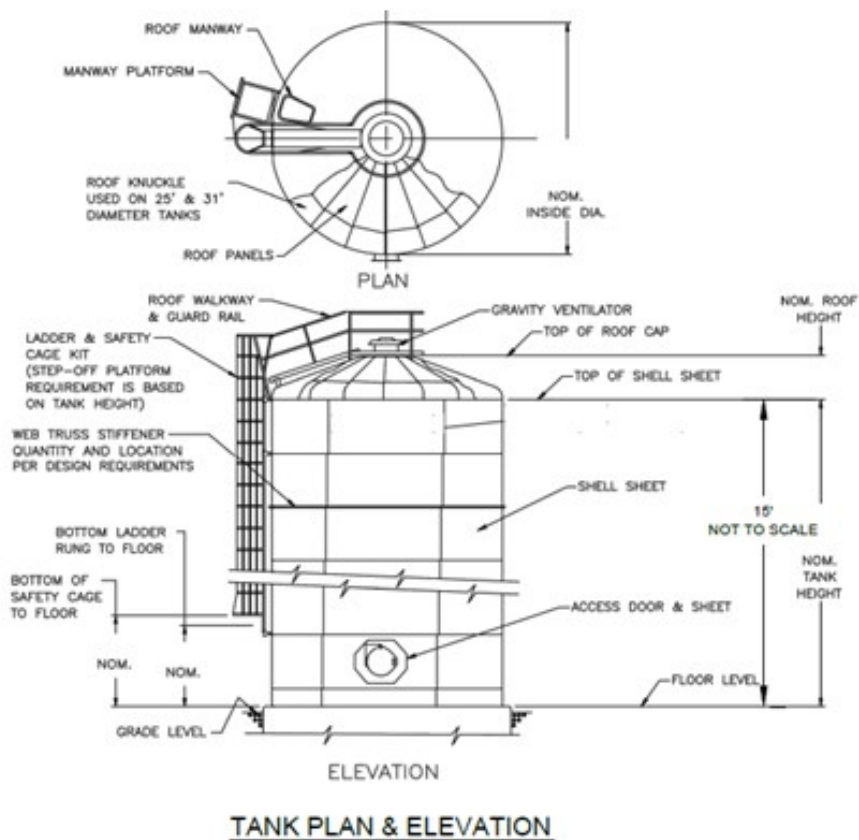

Thank you for your cooperation during this plan review process and if you have any questions, please feel free to call me at (971) 673-0419 or e-mail me at evan.e.hofeld@state.or.us.

Sincerely,

Evan Hofeld, PE
Regional Engineer
Drinking Water Services

cc: Nate Skoglund
CHR Improvement District
3370 Ridge Road
Otis, OR 97368