Name: Mac Gifford

Address: 1900 N Interstate Ave

Phone Number: 503-823-1507

City/State/Zip: Portland, OR 97227

Email Address: mac.gifford@portlandoregon.gov

Center for Health Protection, Drinking Water Services




Application for Waiver from Construction Standards for Public Water Systems

Revised March 2025

Water System Name: Portland Water Bureau	PWS ID:	00657	
Project or Facility: 6" DI Main in N Overlook Terrace	County:	Multnomah	
Need for waiver identified: Water System Survey Date of	of Survey:		
Plan Review # Exempt			
Construction standard requested to be waived: OAR 333-061-0050 (9)	9)(b) water se	ewer separation	
As provided under OAR 333-061-0055, OHA may grant waivers from the construction standards prescribed by these rules:			
(a) When it is demonstrated to the satisfaction of OHA that strict compliance with the rule would be highly burdensome or impractical due to special conditions or causes; and(b) When the public or private interest in the granting of the waiver is found by OHA to clearly			
outweigh the interest of the application of uniform rules; and			
(c) When alternate measures are provided which, in the opinion of protection to the health and safety of the public including the adoes not exceed the maximum contaminant levels listed in rule.	ability to pro	duce water which	
Describe situation that conflicts with the standard. A proposed water	line comes w	vithin 5' parallel	
horizontal separation of an existing combined sewer at station 2+19 to 2+42 and at the tie in from			
station 2+79 to 2+82, creating a zone 2 conflict.			
Describe why meeting the standard is highly burdensome or impractical. The straight sewer does not			
leave room to maintain the standard horizontal separation as the roadway curves.			
Describe proposed alternate measure that provide adequate protection to public health and safety.			
The proposed water line will be encase in CLSM where it is within 5' of the existing sewer.			
EMAIL this form along with plans of proposed waiver request and additional supporting			
information to your regulator or dws.planreview@odhsoha.oregon.gov. If you are unable to			
send your documents electronically, please contact OHA before mailing them.			
Signature: Mac Afford	Date: 9/4/202	24	

800 NE Oregon St., Ste 640, Portland, OR 97232-2162 Voice: 971-673-0405 | Fax: 503-673-0694 All relay calls accepted | www.healthoregon.org/dws

Comments:	Organia ale Taur
Attachments (describe): Improvement plans for 6" DI Main in N	Overlook Terr
OHA Use Only	
Waiver ID: 554-2025	
Entered into waiver database	
✓ Plan Review Coordinator's notes: Proposed encasement with C the Zone 2 conflict.	LSM is an appropriate remedy fo
After due consideration the above requested waiver from the constru 061-0050 is hereby:	action standards of OAR 333-
Approved Comments:	
☐ Denied	
Kari Salis	9/5/2025
Technical Services Unit or Regional Manager OHA Drinking Water Services	Date
Waiver database updated	

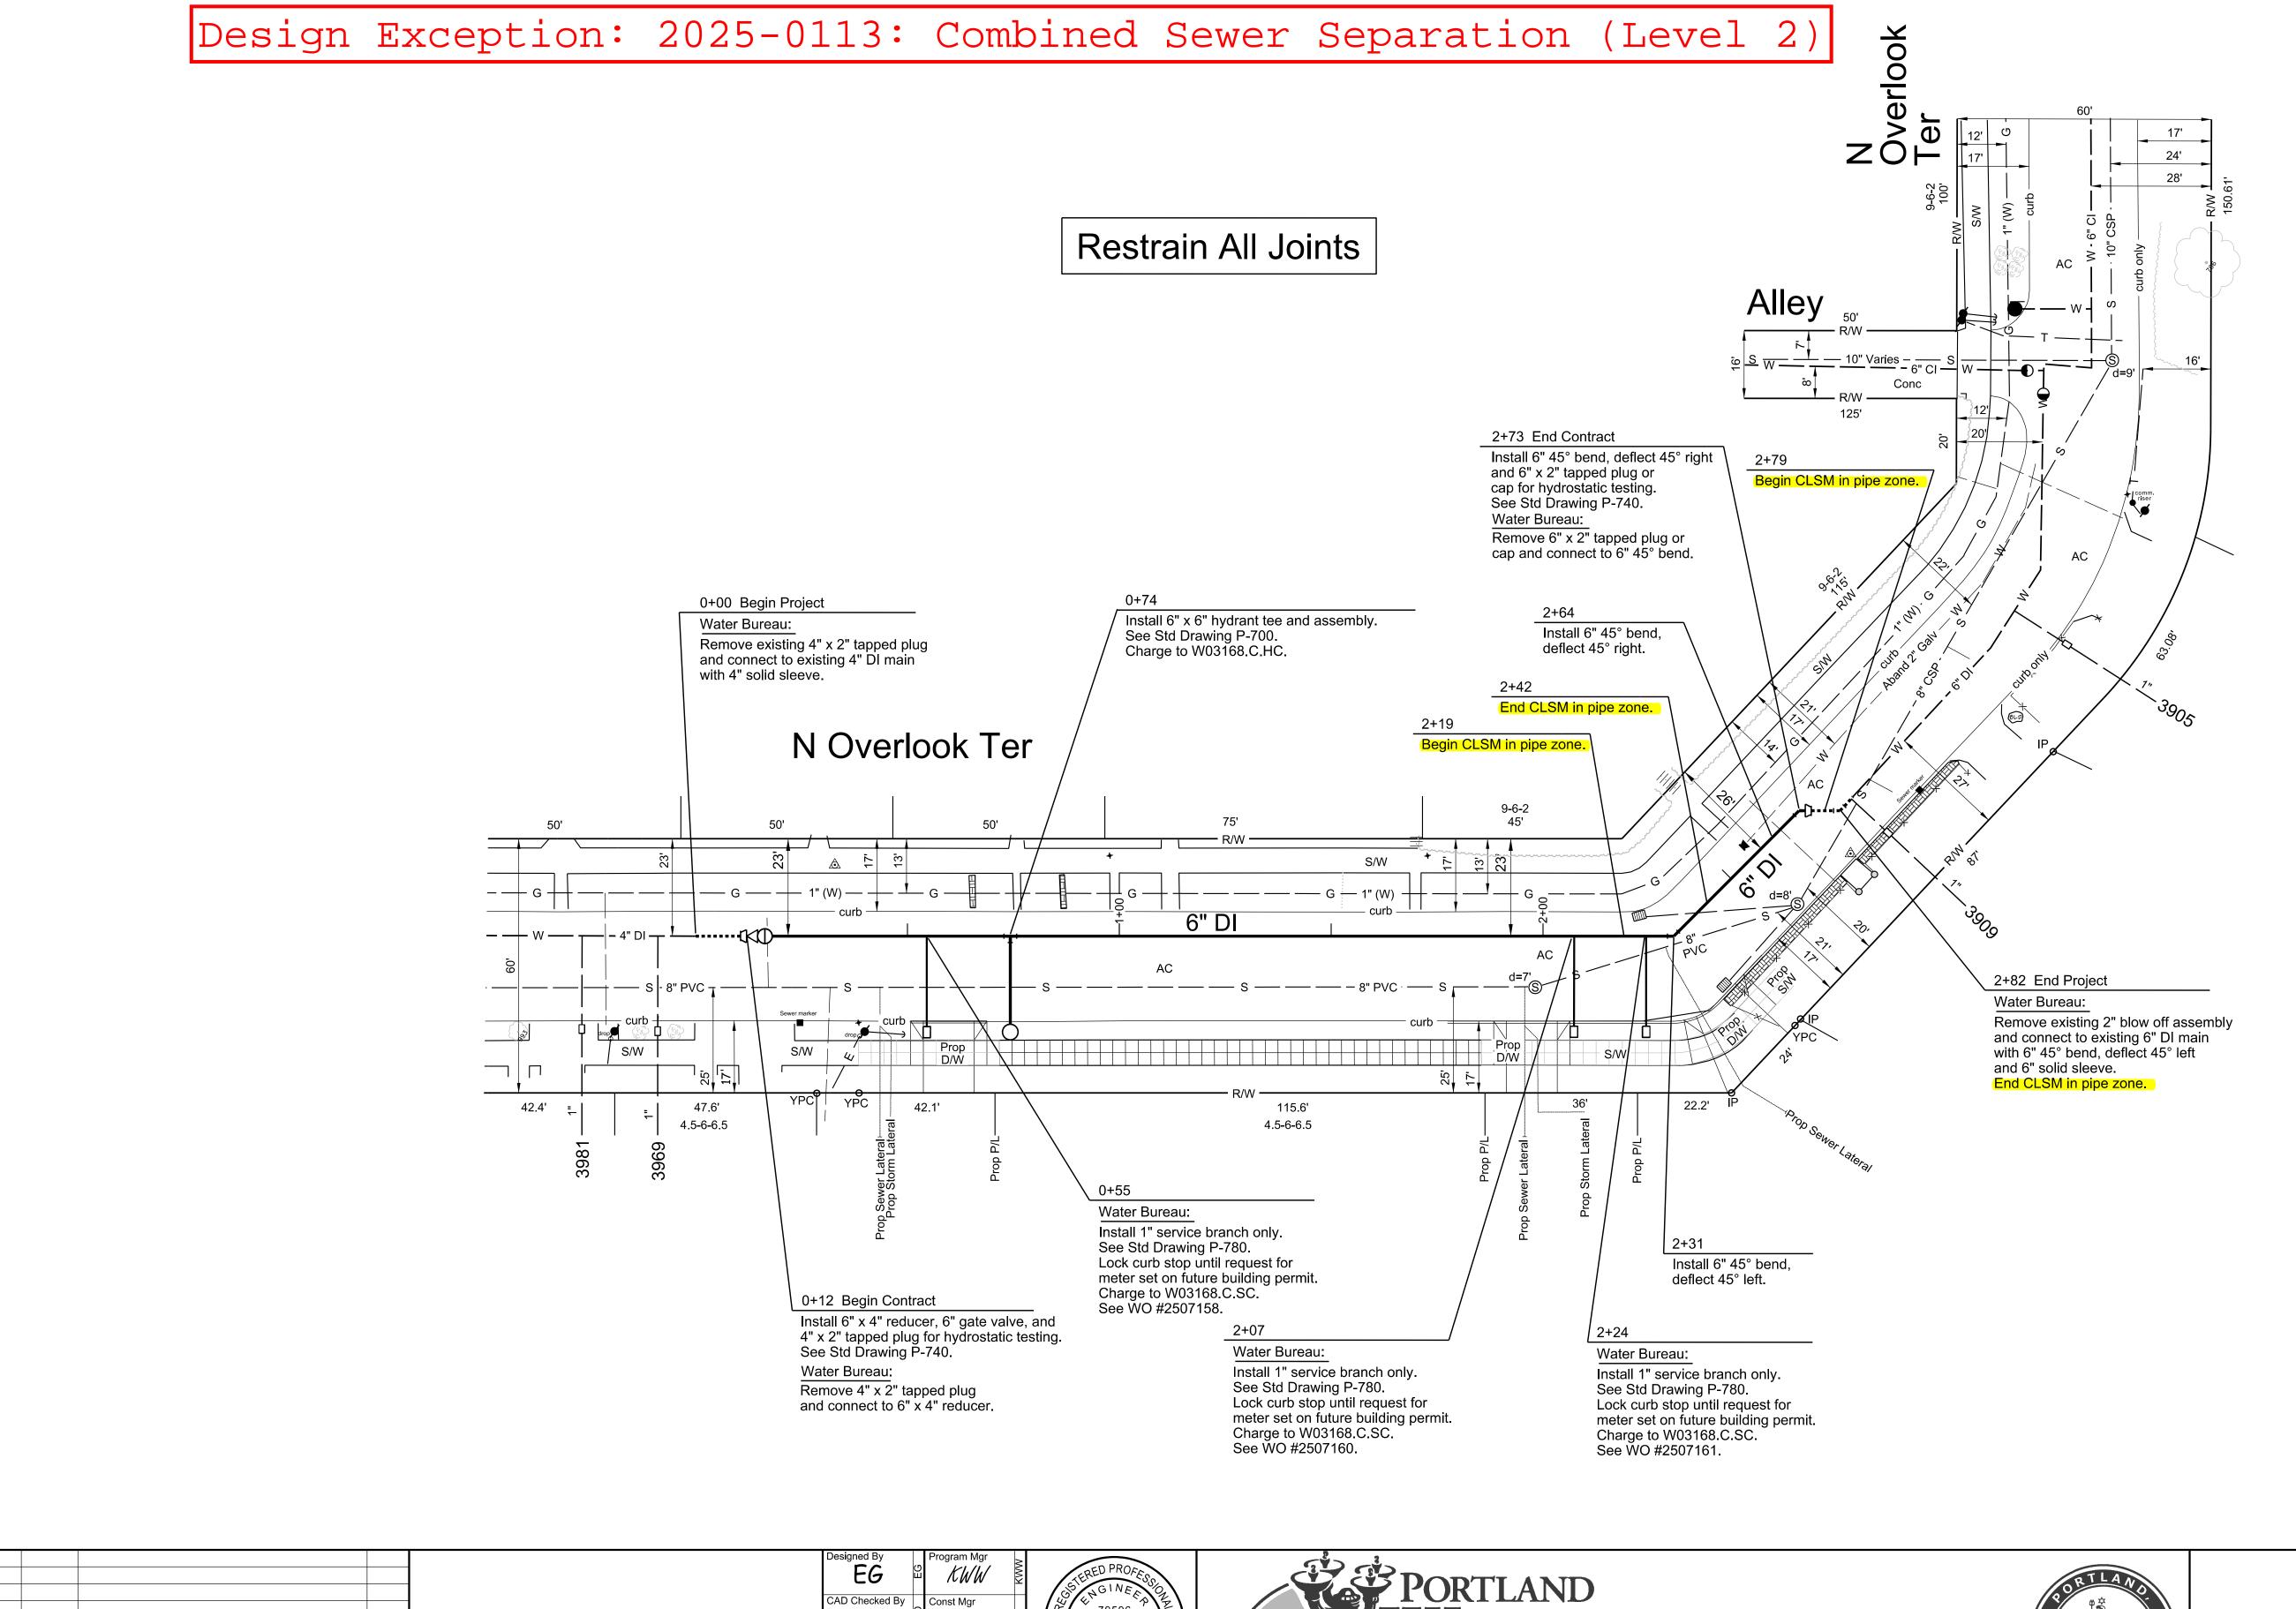

0 10 20
scale in feet
SAP Project No

W03168

1/4 Section

2628

No Date Description Appd
Revision
Survey 04 / 2025 King

EG

CAD Checked By

AAD


Checked By


RBS


Project Mgr

EG

Date

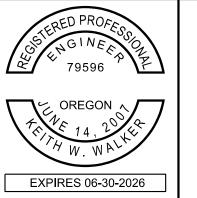

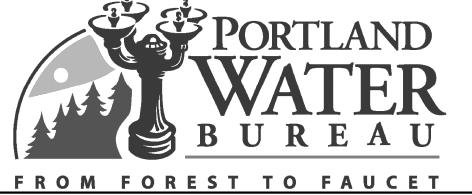

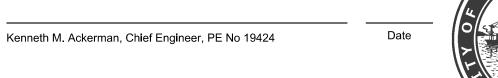

Kenneth M. Ackerman, Principal Engineer, PE No 19424

N Overlook Ter

From 403'± SSL N Overlook Ter To 674'± SSL N Overlook Ter

6" DI Main

or rederiverselver

Plan Sheet

Sheet No

2 of 2